

4

3

2

1

THIS DRAWING IS UNPUBLISHED.

RELEASED FOR PUBLICATION

2000

© COPYRIGHT 2000

BY TYCO ELECTRONICS CORPORATION. ALL RIGHTS RESERVED.

LOC


DIST

REVISIONS

GW

-

P	LTR	DESCRIPTION	DATE	DWN	APVD
	A	-	05APR2001	BL	KM
	A1	REVISED PER ECO-09-026495	30NOV09	KK	AEG

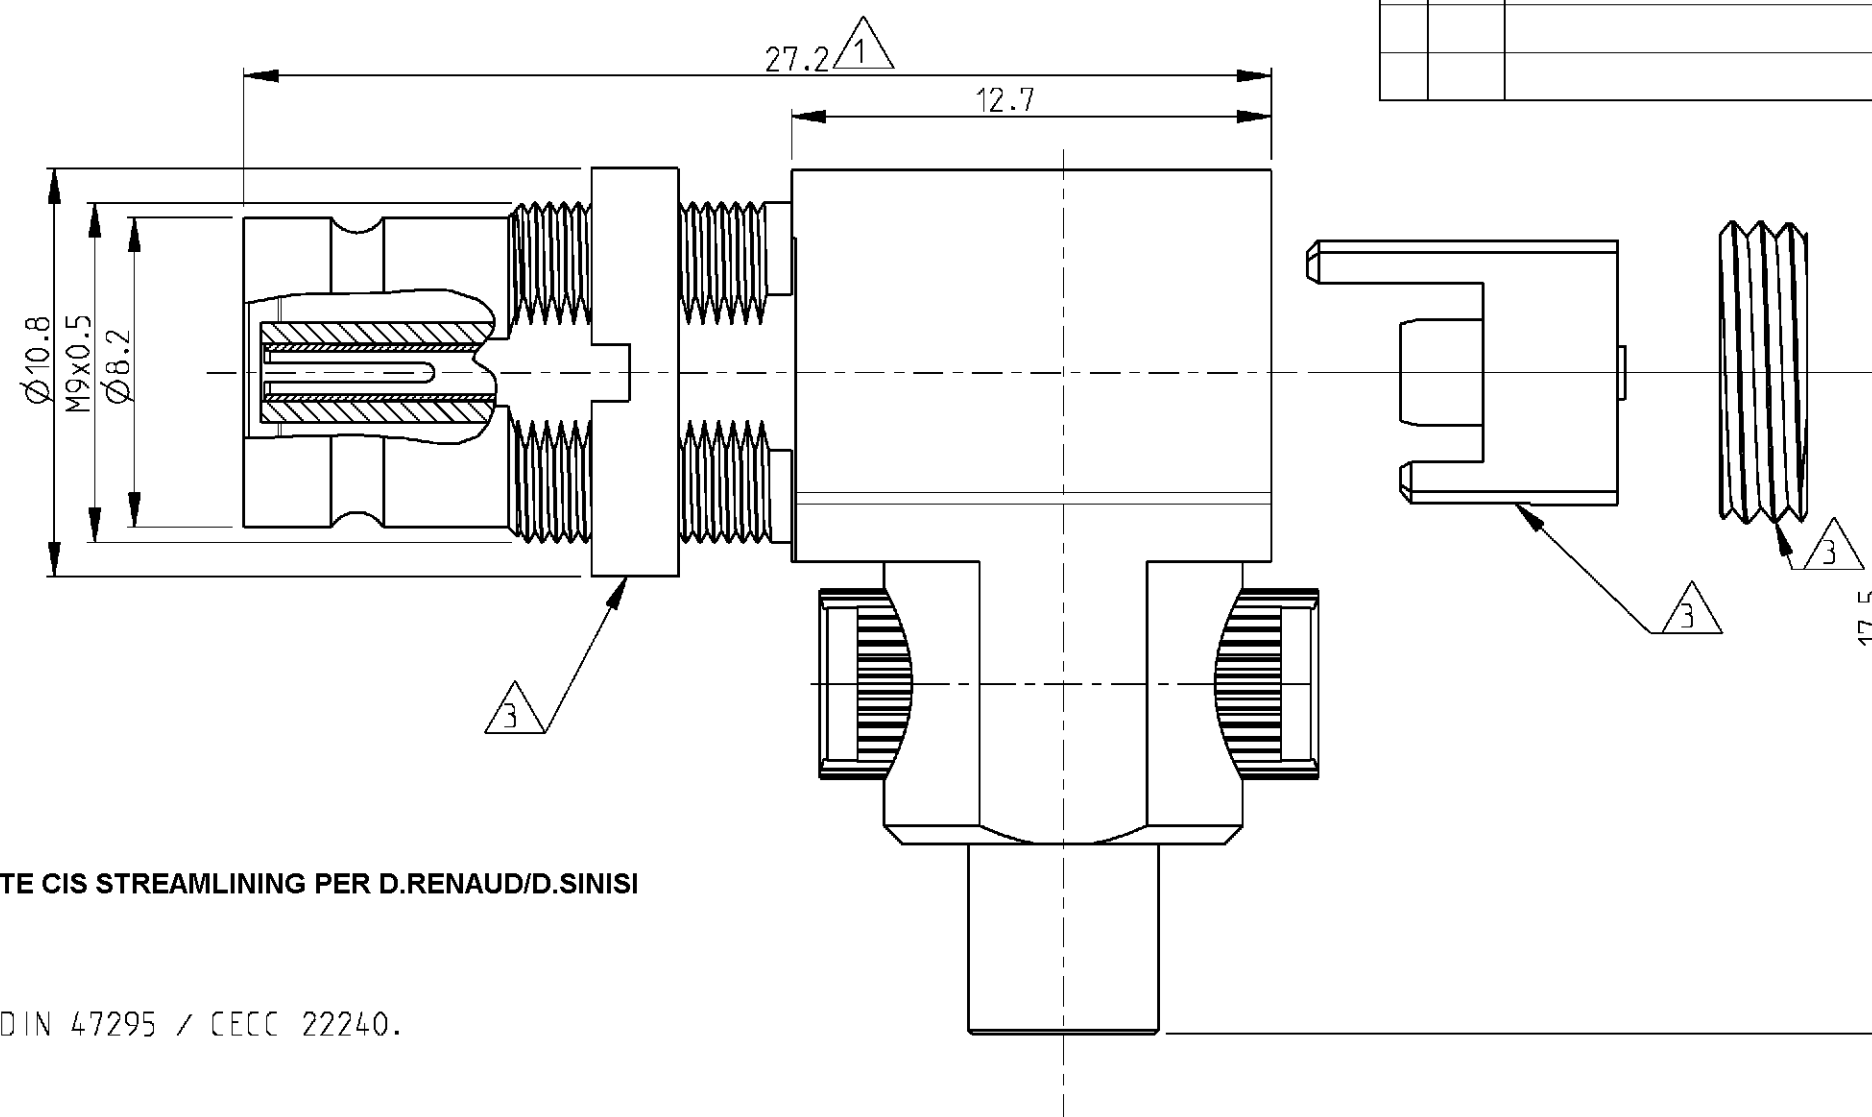

6 OBSOLETE PARTS: OBSOLETE CIS STREAMLINING PER D.RENAUD/D.SINISI


5 Packed in tray

4) Mating face according to DIN 47295 / CECC 22240.


3 Supplied as loose part

2) All dimensions are maximum

1 Dimension when fully constrained.

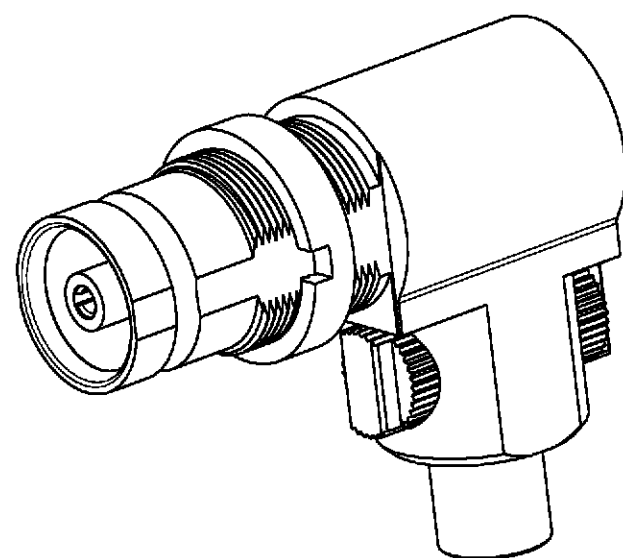

3:1

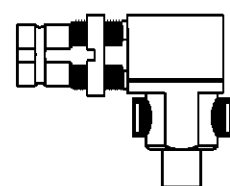

1:1

THIS DRAWING IS A CONTROLLED DOCUMENT FOR TYCO ELECTRONICS CORPORATION
IT IS SUBJECT TO CHANGE AND THE CONTROLLING ENGINEERING ORGANIZATION
SHOULD BE CONTACTED FOR THE LATEST REVISION.

DIMENSIONS:	TOLERANCES UNLESS OTHERWISE SPECIFIED:
mm	
	0 PLC ±
	1 PLC ±
	2 PLC ±
	3 PLC ±
	4 PLC ±
	ANGLES ±
MATERIAL -	FINISH -

DWN	29MAR2001
CHK	B. Lenvain
APVD	05APR2001
	K. Mattheeuws
	05APR2001
	R. Leeman
PRODUCT SPEC	-
APPLICATION SPEC	114-71027
WEIGHT	-
CUSTOMER DRAWING	

tyco Electronics		Tyco Electronics Oostkamp - Belgium	
NAME Right angled cable jack 1.6/5.6 with IDC connection			
SIZE	CAGE CODE	DRAWING NO	RESTRICTED TO
A3	00779	©-1-1393757-6	-
SCALE 5/1		SHEET 1 OF 2	REV A1

LOC	DIST	REVISIONS				
		P	LTR	DESCRIPTION	DATE	APVD
GW	-	-	-	SEE SHEET 1	-	-

Cross reference table						
Old part number	Tyco part number	Description	Material	Plating	Cable type	
V23612-A811-G76A	~~1-1393757-7~~	Outer conductor	Brass	1 µm Au min in contact area	02Y (sT) CY 0.45/2.0	
		Center conductor	CuBe	1 µm Au min in contact area		
		Dielectric	PEEK/PC	-		
V23612-A811-G76	1-1393757-6	Outer conductor	Brass	1 µm Au min in contact area	02Y (sT) CY 0.45/2.0	
		Center conductor	CuBe	1 µm Au min in contact area		
		Dielectric	PEEK/PC	-		
V23612-A811-A24A	1-1393757-5	Outer conductor	Brass	1 µm Au min in contact area	R1-T 2.0 LI-75 k TZC 75025-315/1.95 FH/HF	
		Center conductor	CuBe	1 µm Au min in contact area		
		Dielectric	PEEK/PC	-		
V23612-A811-A24	~~1-1393757-4~~	Outer conductor	Brass	1 µm Au min in contact area	R1-T 2.0 LI-75 k TZC 75025-315/1.95 FH/HF	
		Center conductor	CuBe	1 µm Au min in contact area		
		Dielectric	PEEK/PC	-		

6

OBSOLETE

6

OBSOLETE

THIS DRAWING IS A CONTROLLED DOCUMENT FOR TYCO ELECTRONICS CORPORATION
IT IS SUBJECT TO CHANGE AND THE CONTROLLING ENGINEERING ORGANIZATION
SHOULD BE CONTACTED FOR THE LATEST REVISION.

DIMENSIONS:
mm

MATERIAL
-

FINISH
-

DWN
B. Lenvain

CHK
K. Mattheeuws

APVD
R. Leeman

PRODUCT SPEC
-

APPLICATION SPEC
-

WEIGHT
-

CUSTOMER DRAWING

29MAR2001

09APR2001

09APR2001

NAME
Right angled cable jack
1.6/5.6
with IDC connection

SIZE
A3

CAGE CODE
00779

DRAWING NO
G-1393757-16

RESTRICTED TO
-

SCALE
5/1

SHEET
2

OF
2

REV
A1

tyco
Electronics

Tyco Electronics
Oostkamp - Belgium

AMP 1470-19 REV 31MAR2000

Компания «Океан Электроники» предлагает заключение долгосрочных отношений при поставках импортных электронных компонентов на взаимовыгодных условиях!

Наши преимущества:

- Поставка оригинальных импортных электронных компонентов напрямую с производств Америки, Европы и Азии, а так же с крупнейших складов мира;
- Широкая линейка поставок активных и пассивных импортных электронных компонентов (более 30 млн. наименований);
- Поставка сложных, дефицитных, либо снятых с производства позиций;
- Оперативные сроки поставки под заказ (от 5 рабочих дней);
- Экспресс доставка в любую точку России;
- Помощь Конструкторского Отдела и консультации квалифицированных инженеров;
- Техническая поддержка проекта, помощь в подборе аналогов, поставка прототипов;
- Поставка электронных компонентов под контролем ВП;
- Система менеджмента качества сертифицирована по Международному стандарту ISO 9001;
- При необходимости вся продукция военного и аэрокосмического назначения проходит испытания и сертификацию в лаборатории (по согласованию с заказчиком);
- Поставка специализированных компонентов военного и аэрокосмического уровня качества (Xilinx, Altera, Analog Devices, Intersil, Interpoint, Microsemi, Actel, Aeroflex, Peregrine, VPT, Syfer, Eurofarad, Texas Instruments, MS Kennedy, Miteq, Cobham, E2V, MA-COM, Hittite, Mini-Circuits, General Dynamics и др.);

Компания «Океан Электроники» является официальным дистрибьютором и эксклюзивным представителем в России одного из крупнейших производителей разъемов военного и аэрокосмического назначения «JONHON», а так же официальным дистрибьютором и эксклюзивным представителем в России производителя высокотехнологичных и надежных решений для передачи СВЧ сигналов «FORSTAR».



JONHON

«JONHON» (основан в 1970 г.)

Разъемы специального, военного и аэрокосмического назначения:

(Применяются в военной, авиационной, аэрокосмической, морской, железнодорожной, горно- и нефтедобывающей отраслях промышленности)

«FORSTAR» (основан в 1998 г.)

ВЧ соединители, коаксиальные кабели,
кабельные сборки и микроволновые компоненты:

(Применяются в телекоммуникациях гражданского и специального назначения, в средствах связи, РЛС, а так же военной, авиационной и аэрокосмической отраслях промышленности).



Телефон: 8 (812) 309-75-97 (многоканальный)

Факс: 8 (812) 320-03-32

Электронная почта: ocean@oceanchips.ru

Web: <http://oceanchips.ru/>

Адрес: 198099, г. Санкт-Петербург, ул. Калинина, д. 2, корп. 4, лит. А